


1ST FLOOR PLAN

SCALE: 1/8" = 1'-0"

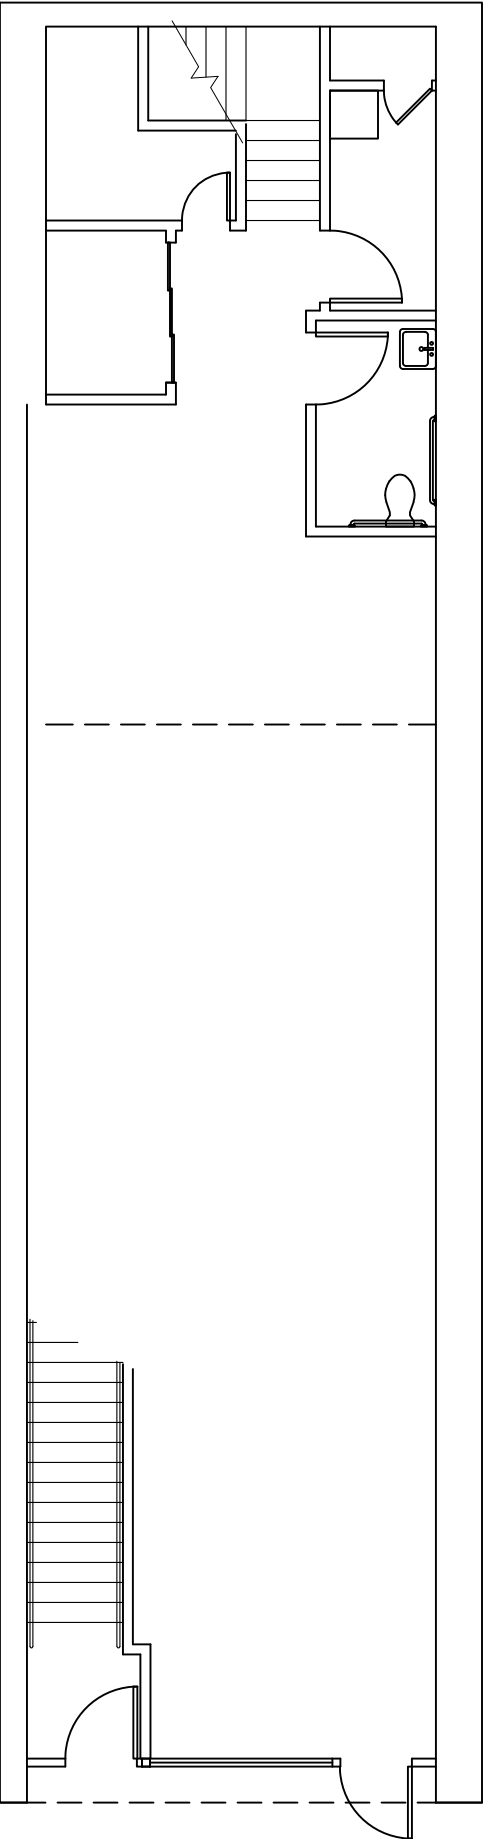

MEZZANINE PLAN

SCALE: 1/8" = 1'-0"